
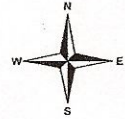


LEGEND


- US Highway
- State Highway
- County Highway
- Township Road
- County Forest Road
- Municipal Road
- Private Drive
- Rail Road
- Driveway
- Incident Command Post
- Dry Hydrant
- Water Point
- Town Hall
- Fire Station
- Hospital/Clinic
- City Hall
- School
- Airport
- Structure
- Horse Trail
- Ski Trail
- Snowmobile / ATV Trail
- Municipal Boundary
- Section Line
- Stream
- Lake or River
- Cell Tower

# Town of Madge, Long Lake (N) T38N-R11W

Map Area Shown in RED

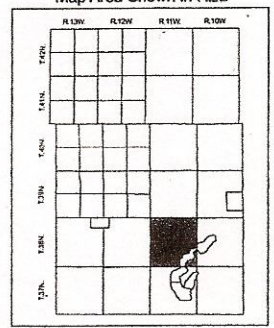

SEE PAGE 35

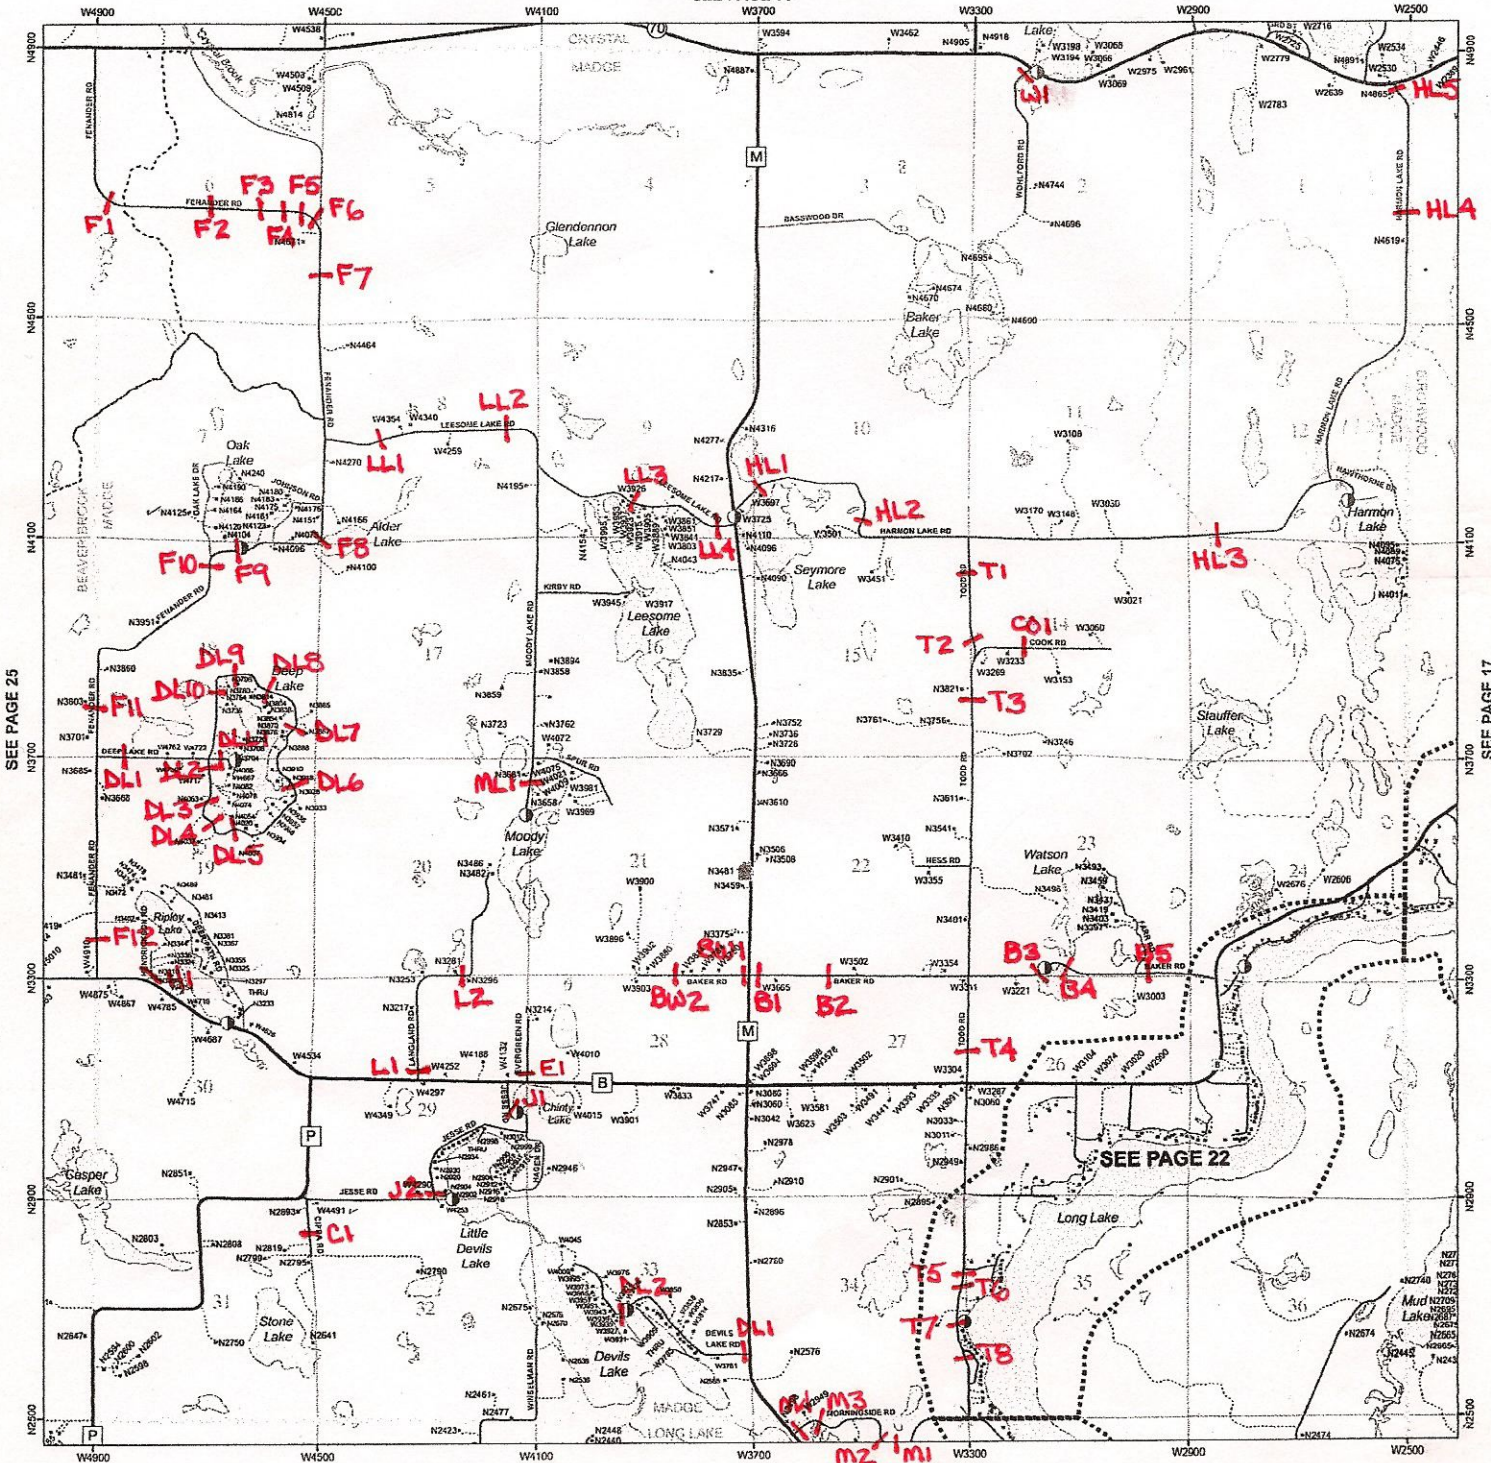

SEE PAGE 25

SEE PAGE 17

SEE PAGE 22

SEE PAGE 5

